


1 FRONT STREET
SUITE 1900
7,014 RSF

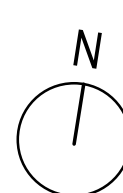

**PARAMOUNT
GROUP, INC.**