


1 FRONT STREET

SUITE 1950

10,985 RSF

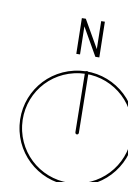

**PARAMOUNT
GROUP, INC.**

